


แบบแปลนผ้า

สำหรับงานซ่อมแซมฉนวนหุ้มท่อในระบบท่อส่งน้ำเครื่องปรับอากาศ ชั้นใต้ดิน - ชั้น ๕ อาคารวิจัยทางการแพทย์ และ
ซ่อมฉนวนใหม่ในระบบท่อส่งน้ำเครื่องปรับอากาศ อาคารวิจัยทางการแพทย์ ชั้น ๖-๙



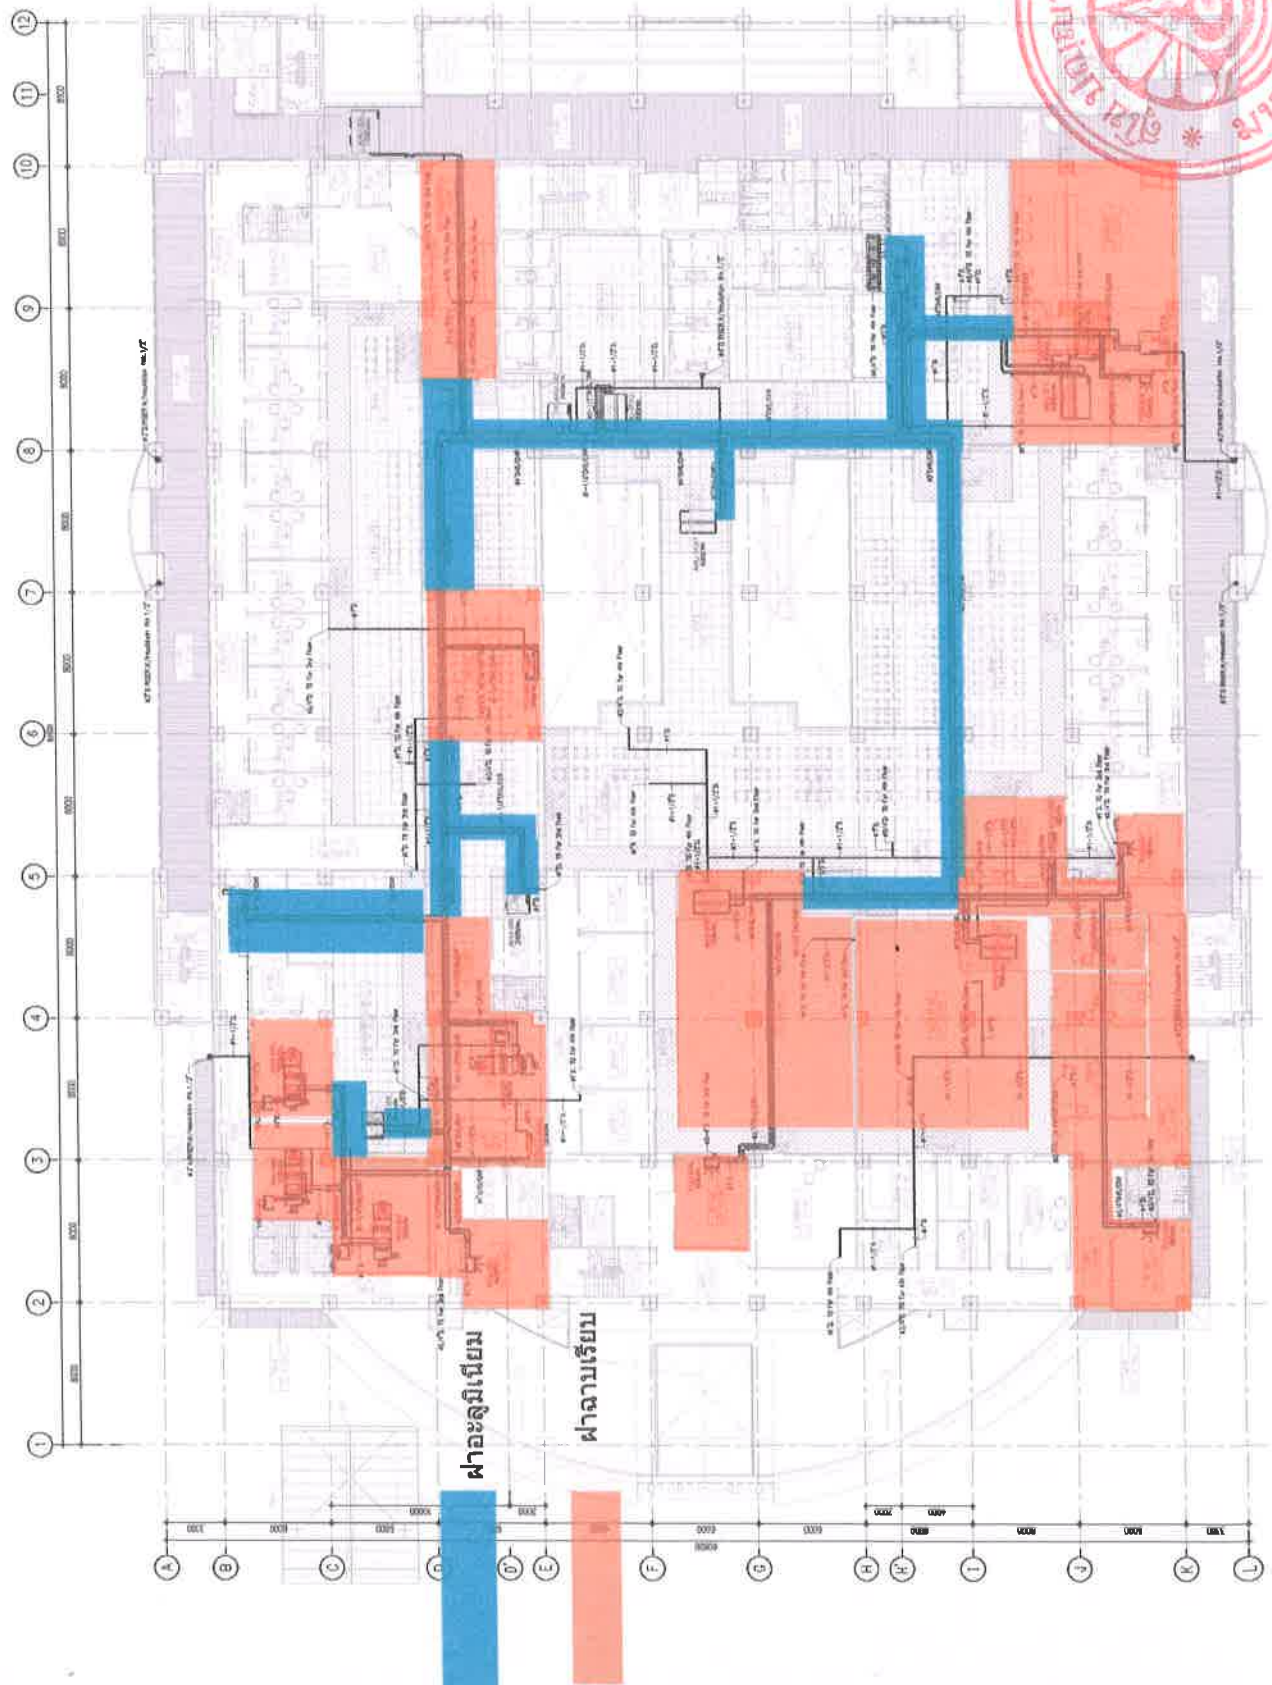


ศาลาอเนกประสงค์
อาคารเรียน

แปลนอาคารพหุหน้าที่ 3
SCALE 1:500MM



 บริษัท ราชภัฏนครพนม จำกัด 100/1 หมู่ 10 ตำบลท่าบ่อ อำเภอเมือง จังหวัดนครพนม โทรศัพท์ 042-2511111 โทรสาร 042-2511112 www.rcc.ac.th		 มหาวิทยาลัยราชภัฏนครพนม 100/1 หมู่ 10 ตำบลท่าบ่อ อำเภอเมือง จังหวัดนครพนม โทรศัพท์ 042-2511111 โทรสาร 042-2511112 www.rcc.ac.th		REVISION <table><tr><th>NO.</th><th>DESCRIPTION</th><th>DATE</th></tr><tr><td>1</td><td>ISSUED FOR PERMIT</td><td>10/10/2561</td></tr><tr><td>2</td><td>FOR CONSTRUCTION</td><td>10/10/2561</td></tr></table>	NO.	DESCRIPTION	DATE	1	ISSUED FOR PERMIT	10/10/2561	2	FOR CONSTRUCTION	10/10/2561	AS BUILT DRAWING
NO.	DESCRIPTION	DATE												
1	ISSUED FOR PERMIT	10/10/2561												
2	FOR CONSTRUCTION	10/10/2561												
AS BUILT DRAWING														

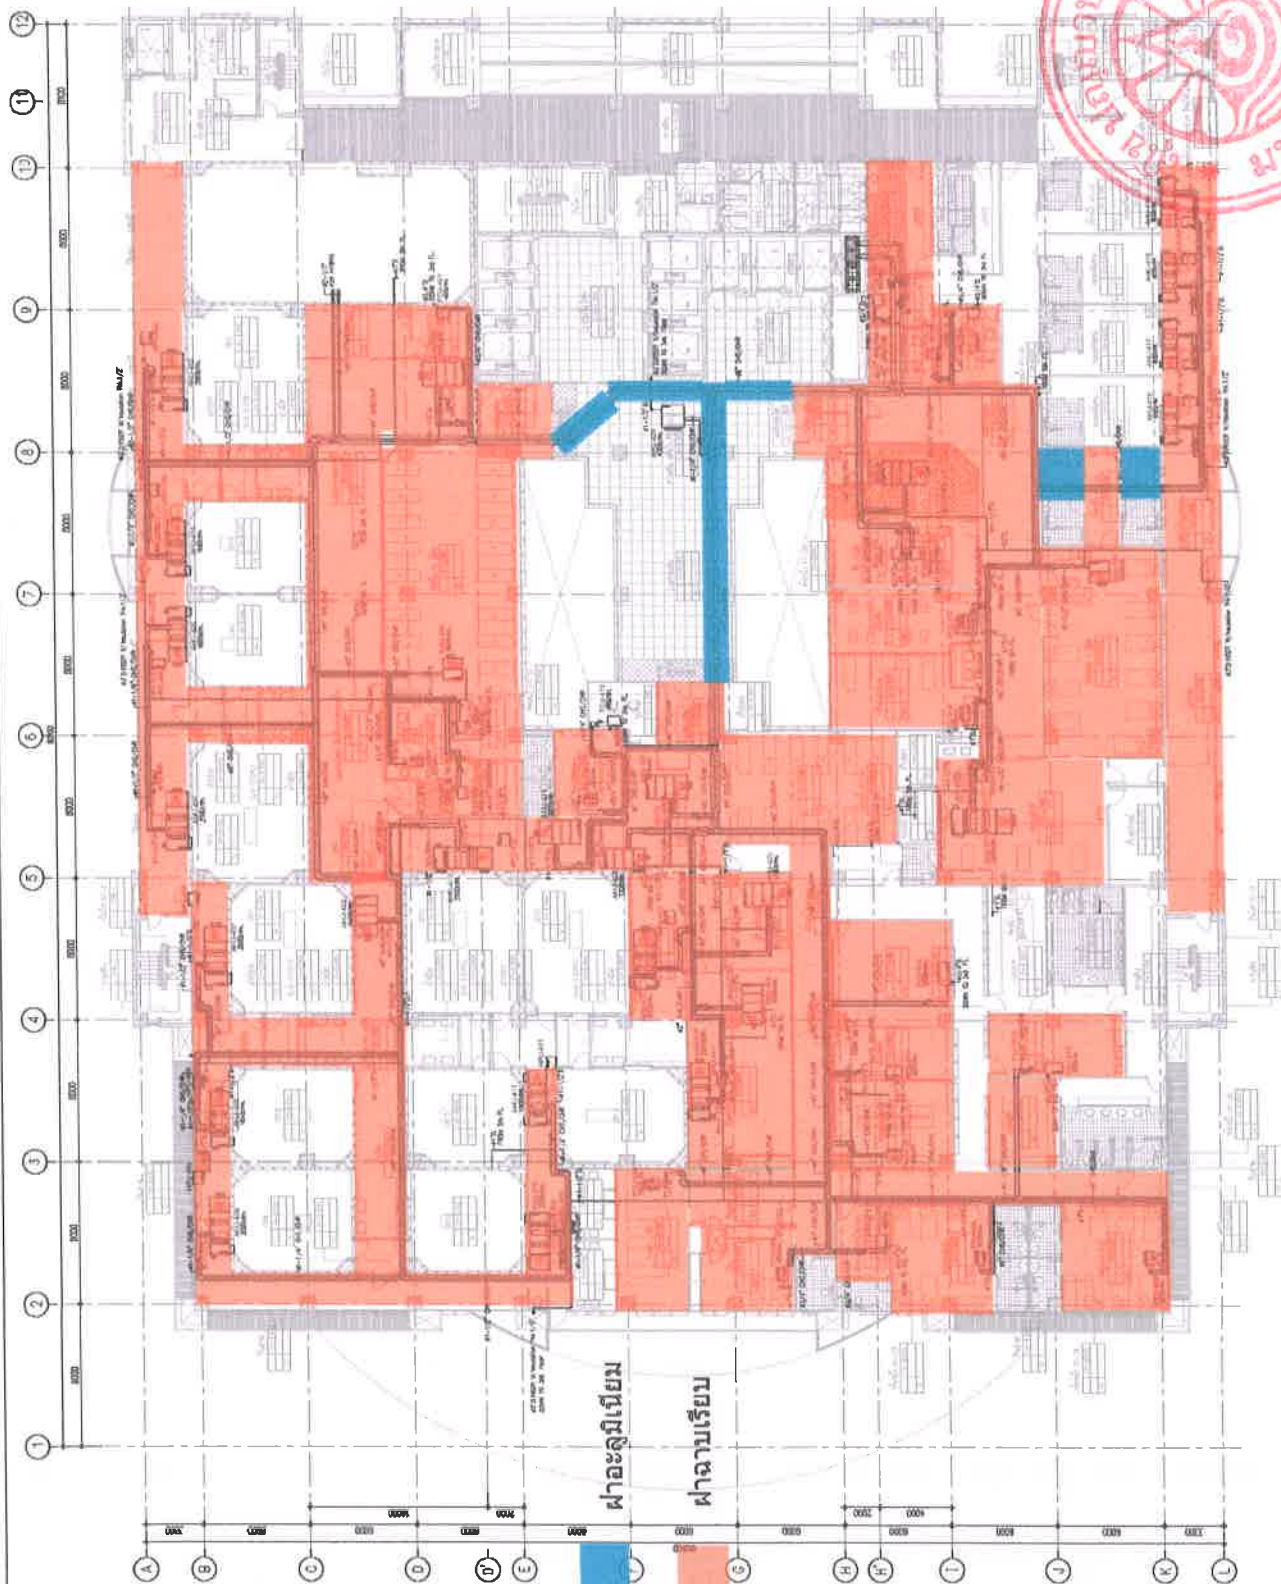

ຝາຂະສູນີເປີຍມ

ผ่าฉาบเรียบ


แปลนระบายน้ำ หน้า 4
SCALE 1:150000

$$\frac{1}{1.50 \times 10^{-1}}$$
[illegible]

1. *Phragmites*

DATE	10/14/00	PROJECT NO.	007814
TIME	11:00 AM		
BY			
DATE		PROJECT NO.	AC-05
BY			

AS BUILT DRAWING

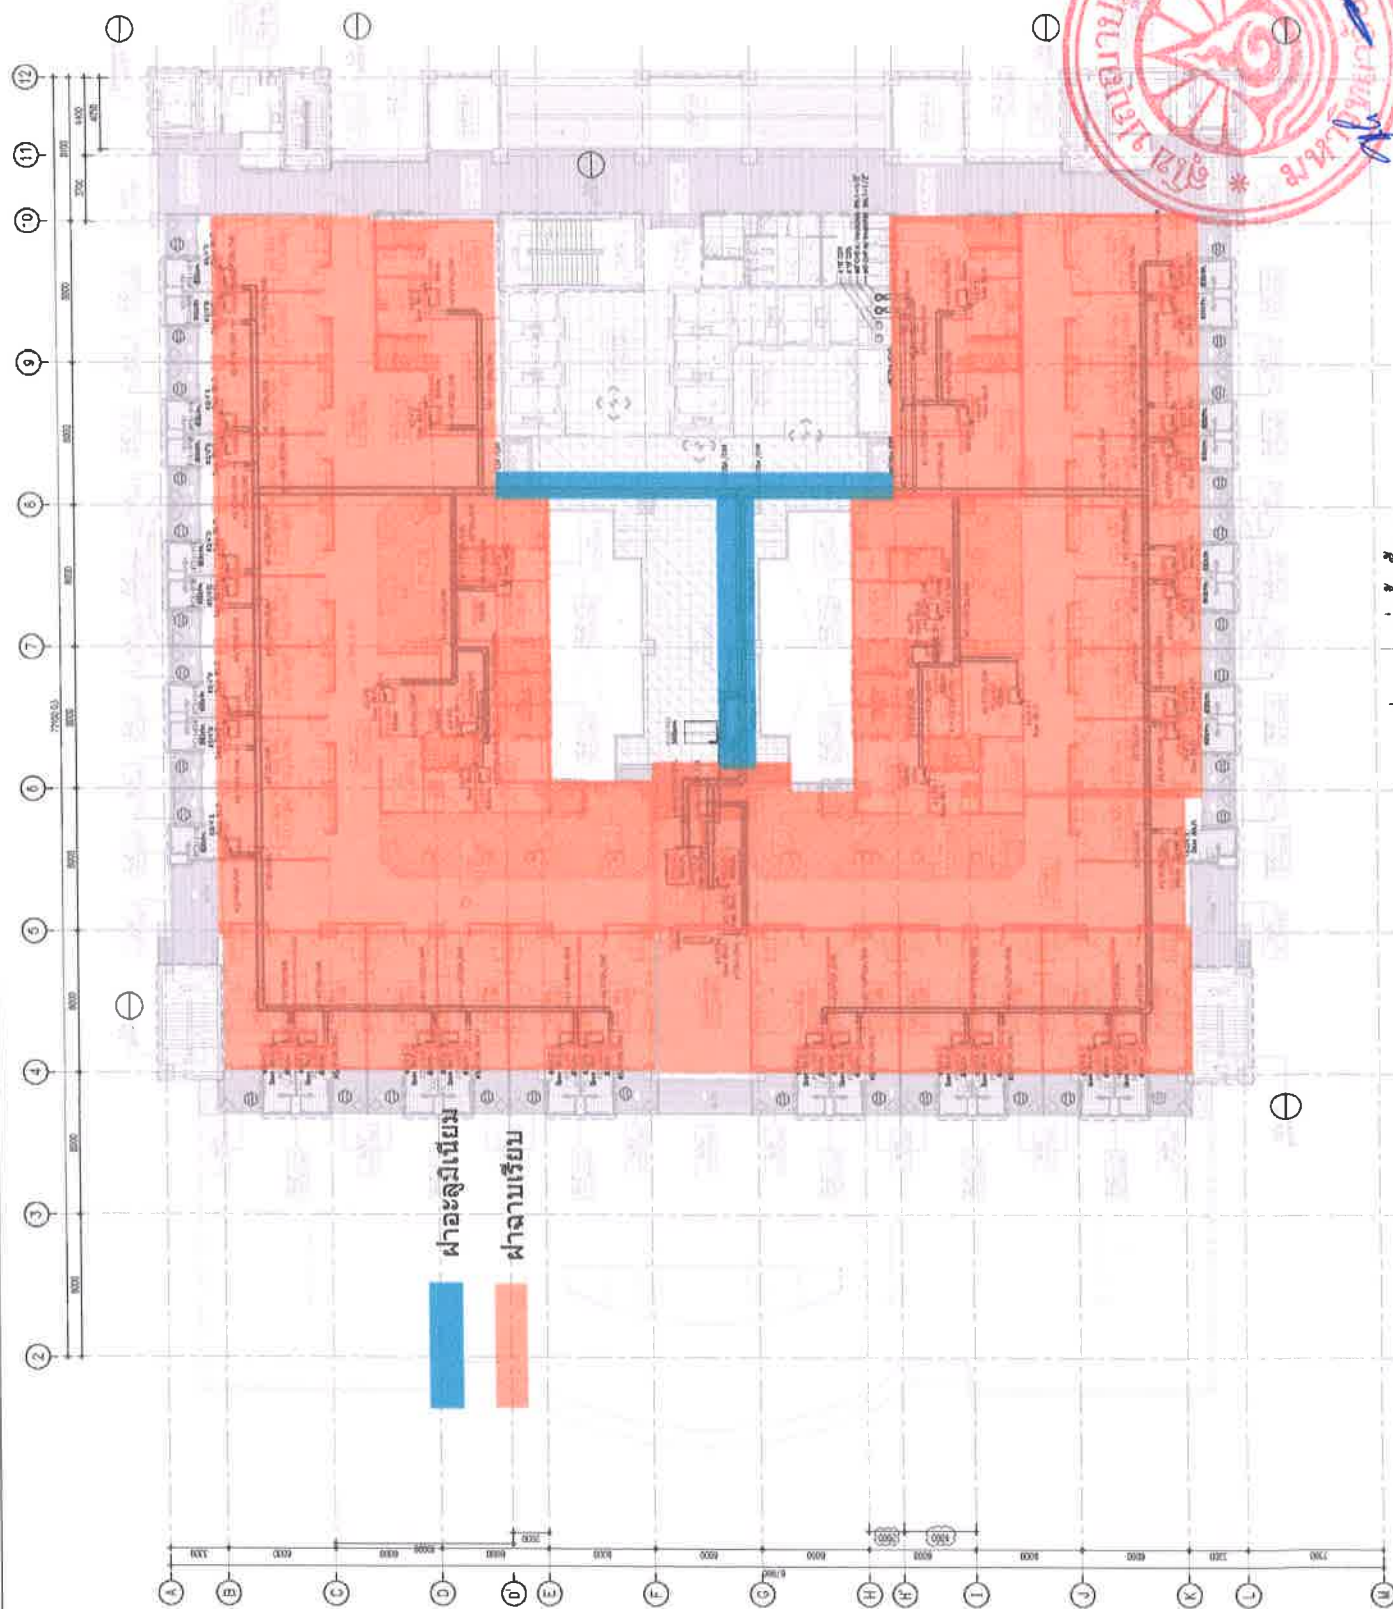

SCALE 1:150000

1:15PM

[illegible]