



แบบแปลนว่าแล้ว

สำหรับงานซ่อมแซมฉนวนหุ้มท่อไ้ในระบบท่อส่งน้ำเครื่องปรับอากาศ ชั้นใต้ดิน - ชั้น๕ อาคารวิจัยทางการแพทย์ และ
ซ่อมฉนวนใหม่ในระบบท่อส่งน้ำเครื่องปรับอากาศ อาคารวิจัยทางการแพทย์ ชั้น ๖-๙

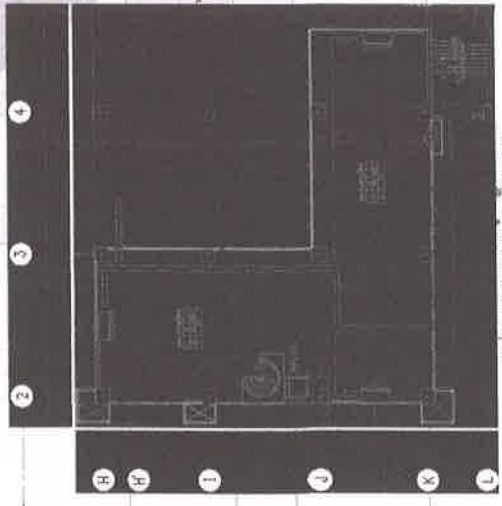

Handwritten signatures in blue ink, including one that appears to be "นพ." (Dr.) and another that is a stylized signature.

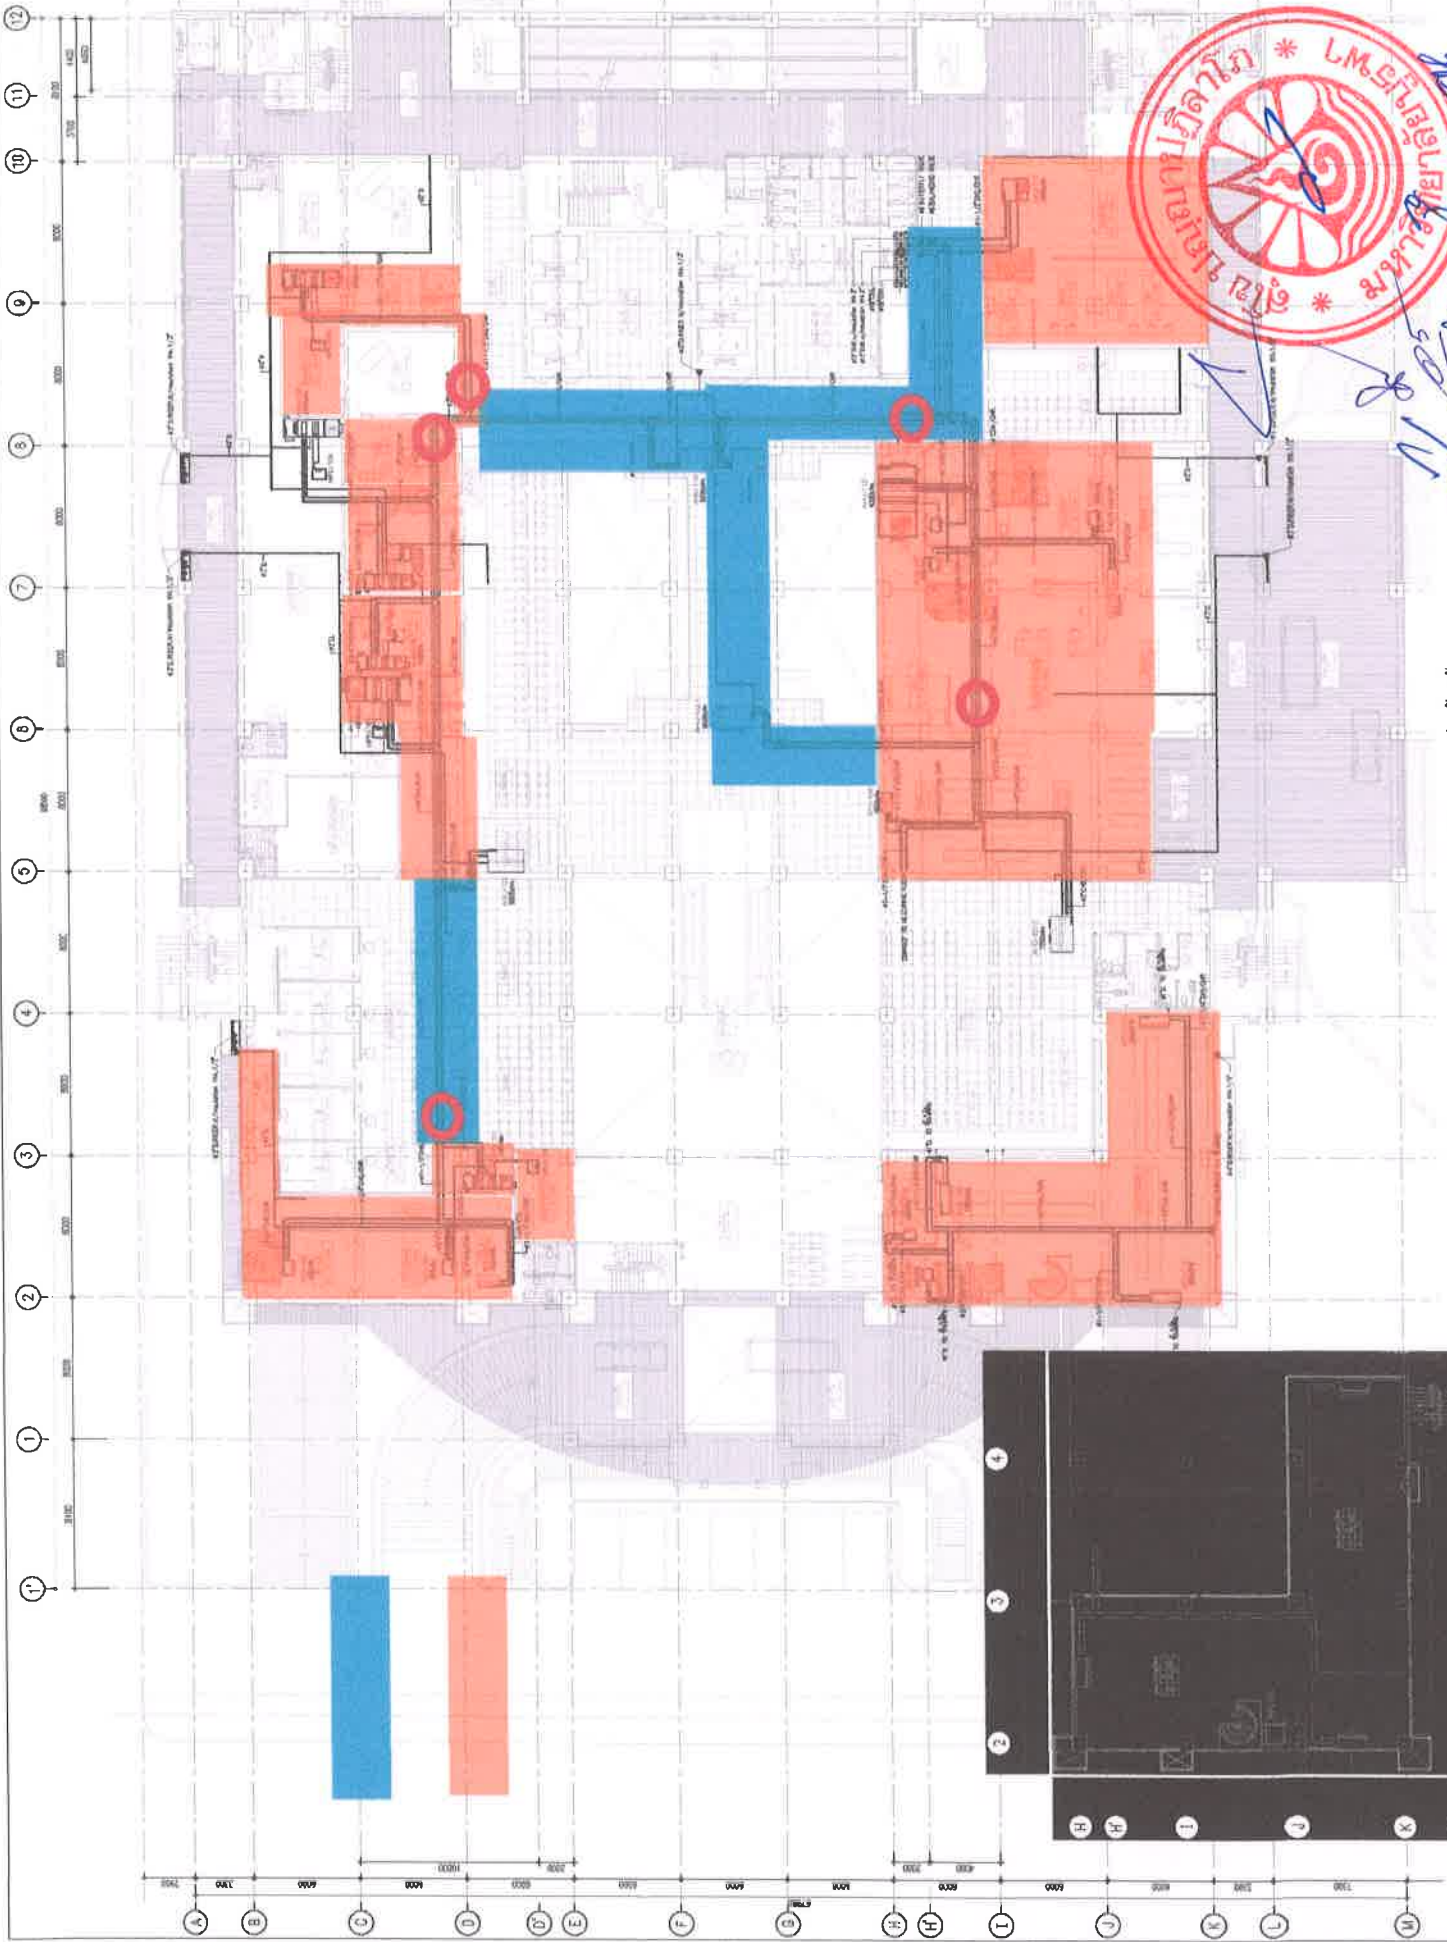


แปลนระบบพวงน้ำ ชั้นลอย
SCALE 1:1000

แปลนระบบพวงน้ำ ชั้น 1
SCALE 1:1500



AS BUILT DRAWING	

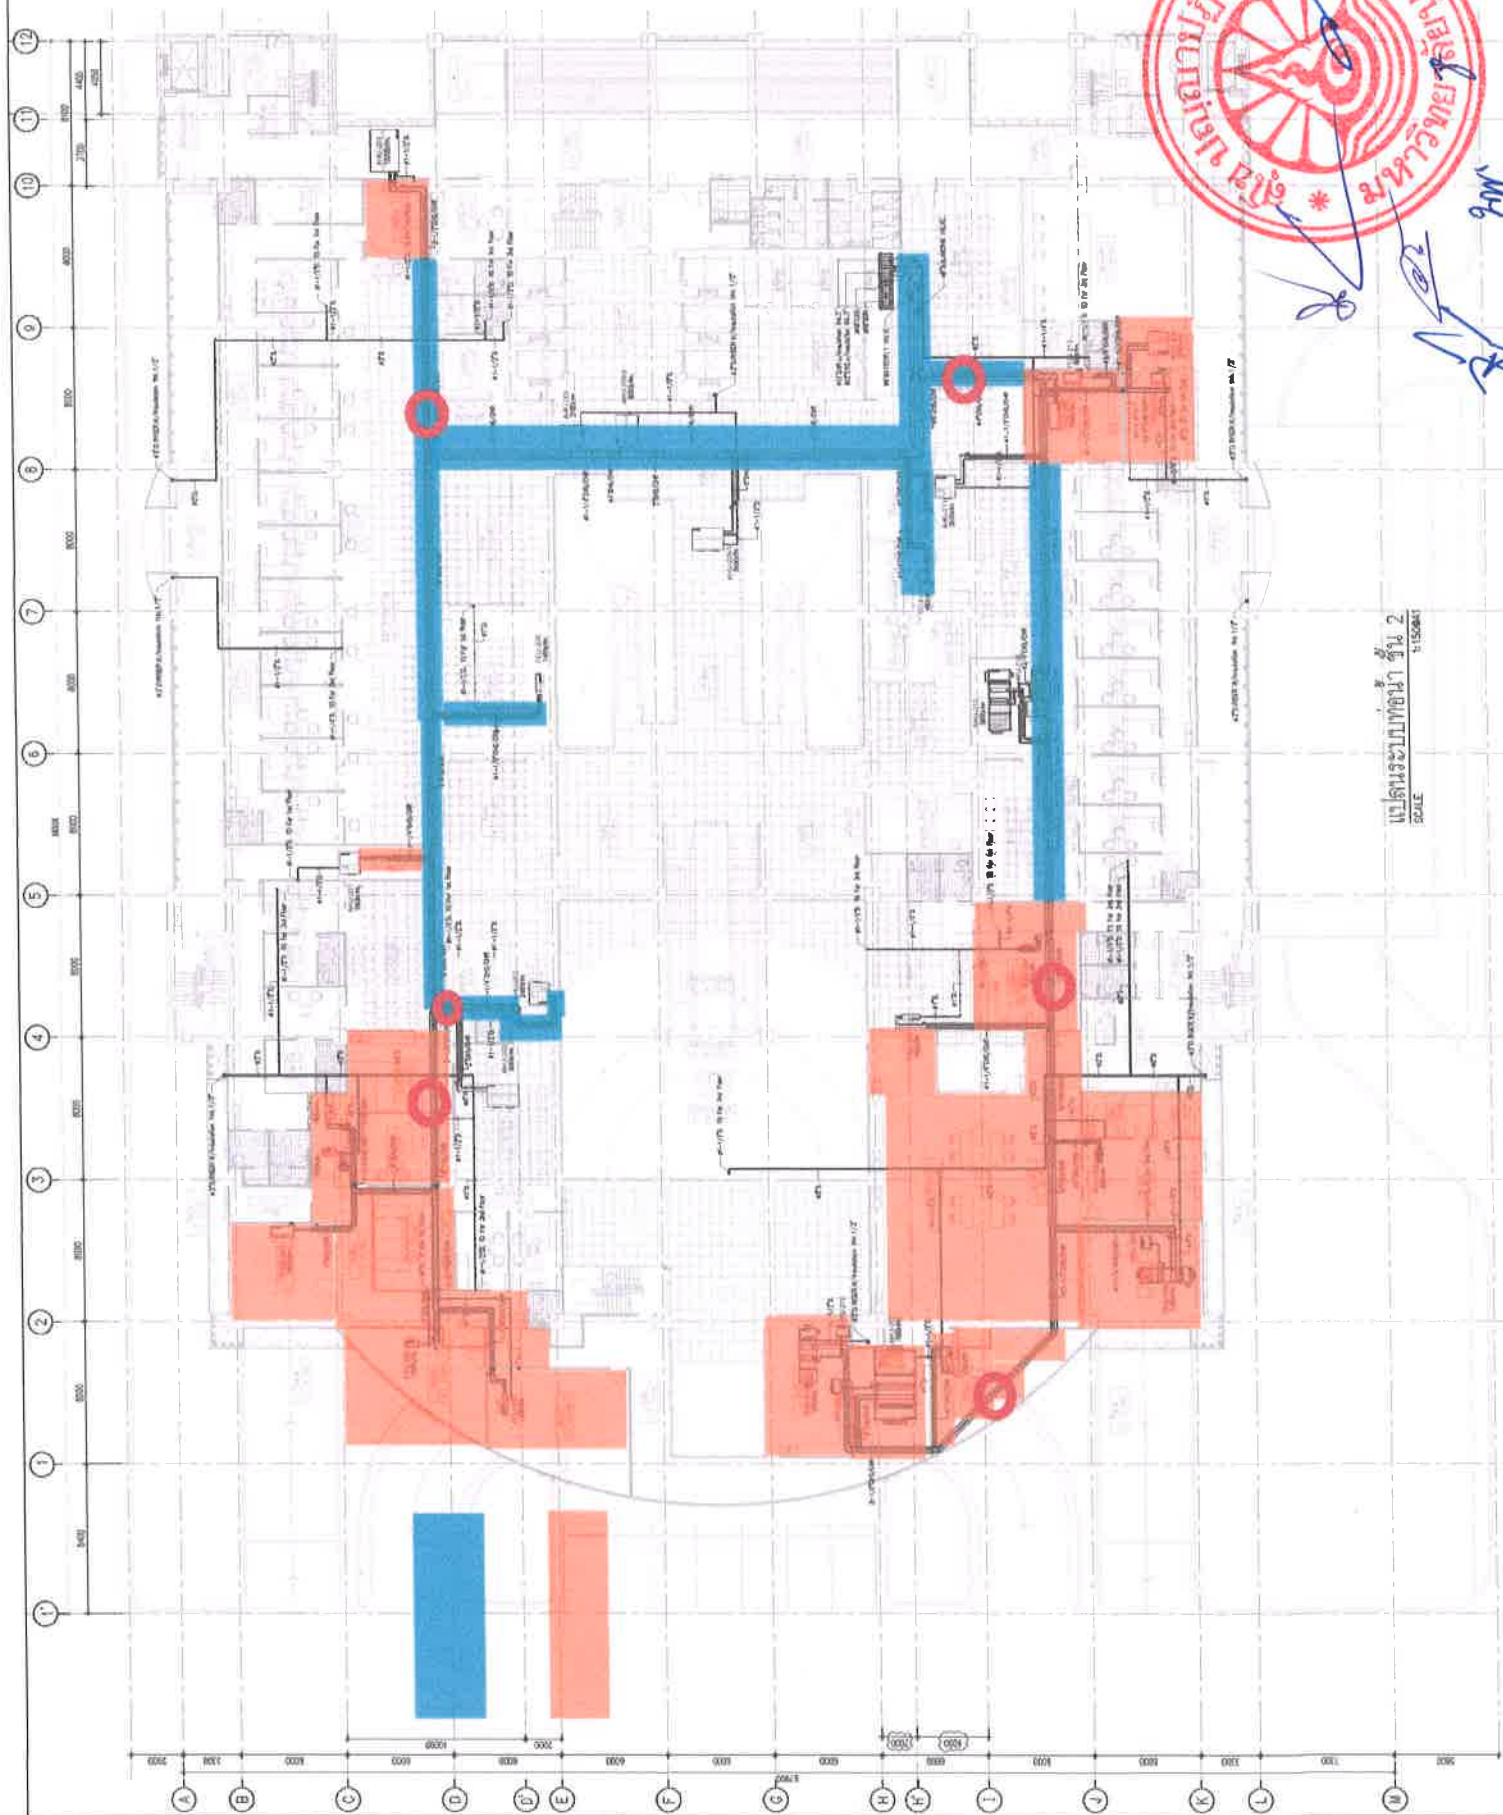


SCALE



SCALE 1:1500



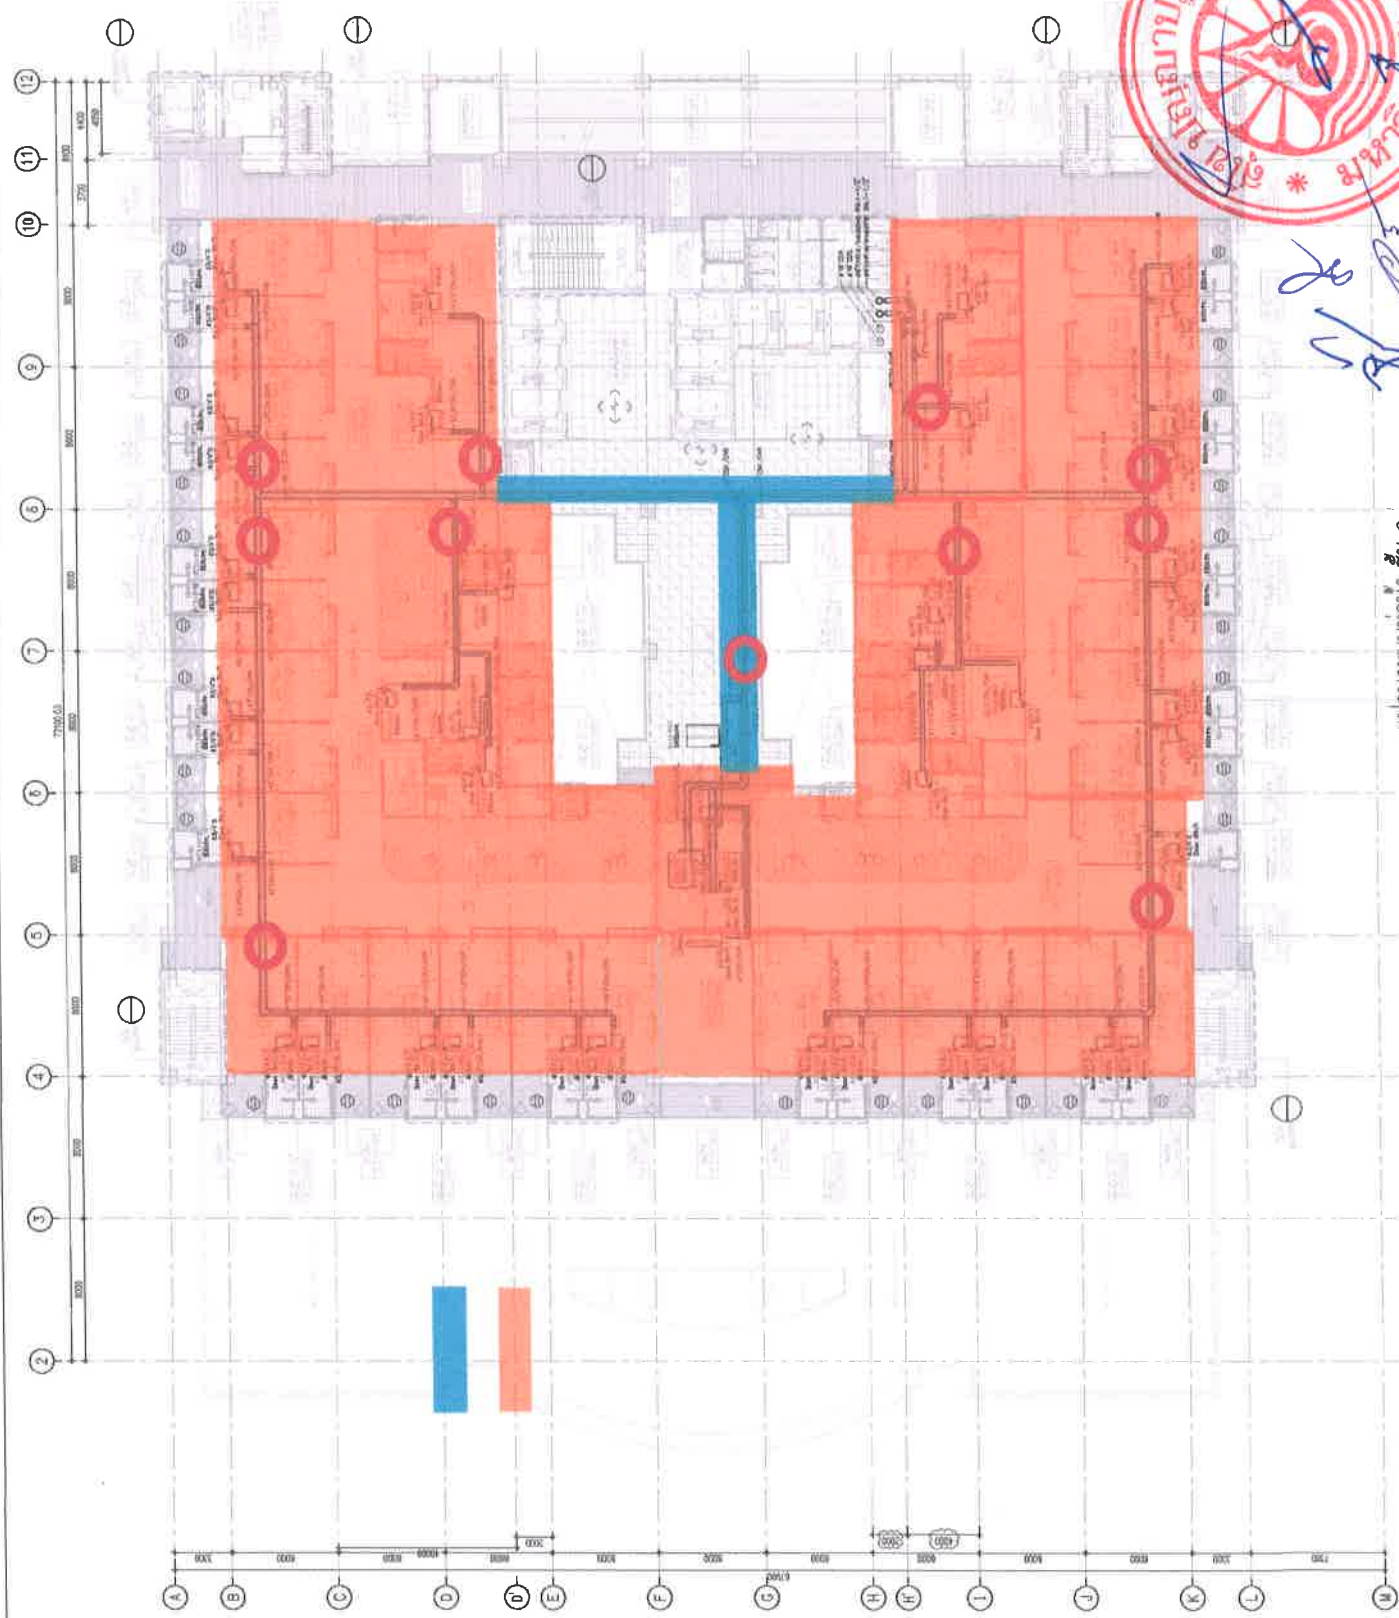

แปลนระบบท่อน้ำ ชั้น 9
SCALE 1:15000